



Money Island Channel

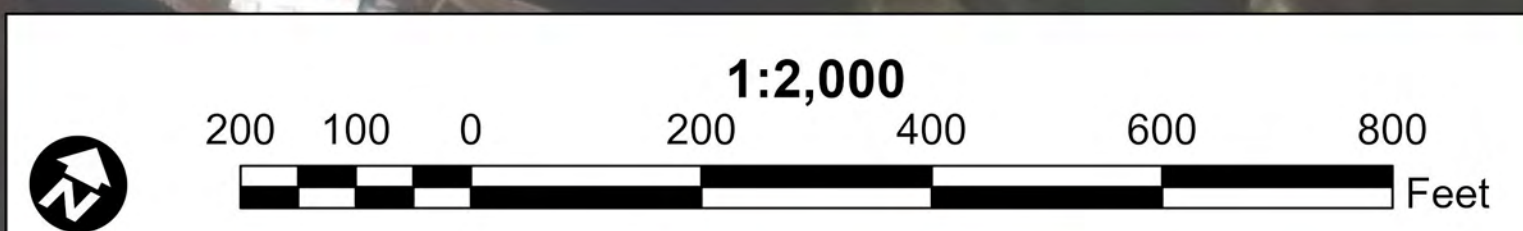

LEGEND	
Green diamond	Can
Purple diamond	Nun
Red diamond	Danger Sign
Green square	Green Daybeacon
Red square	Red Daybeacon
Green circle	Junction Marker
Green circle with light	Green Light
Red circle with light	Red Light
Green circle with buoy	Green Lighted Buoy
Red circle with buoy	Red Lighted Buoy
Red square with buoy	Mileboard
Red line	Matchlines
White line	Navigation Channel
Green line	Placement Areas
Color swatches	Elevation
Dark red	4 and Shallower
Red	6 - 4
Orange	7 - 6
Yellow	8 - 7
Light green	10 - 8
Green	12 - 10
Light blue	14 - 12
Blue	15 - 14
Dark blue	15 and Deeper

NOTES:

- ELEVATIONS ARE IN FEET AND REFER TO NOAA'S REPORTED MEAN LOWER LOW WATER (MLLW) RELATIVE TO THE 1983-2001 TIDAL EPOCH.
- PROJECT SURVEYED WITH DISTRICT SURVEY VESSEL "WALT", USING RTK GPS HORIZONTAL POSITIONING EQUIPMENT AND 200 KHZ SOUNDING EQUIPMENT.
- HORIZONTAL DATUM NAD 1983. VERTICAL DATUM M.L.L.W..
- TIDE GAGE LOCATED AT DAYBEACON A. USE OF TIDE VALUES FOR THIS GAGE ARE RESTRICTED TO QUALITY ASSURANCE PURPOSES FOR VERIFICATION OF RTK TIDES. THE WILMINGTON DISTRICT WILL ONLY USE STAFF GAGE TIDAL VALUES FOR FINAL MAPPING AND QUANTITY CALCULATIONS IF RTK GPS IS UNAVAILABLE AT THE TIME OF SURVEY.
- THIS PROJECT WAS DESIGNED BY THE WILMINGTON DISTRICT OF THE U.S. ARMY CORPS OF ENGINEERS. THE INITIALS AND SIGNATURES AND REGISTRATION DESIGNATIONS OF INDIVIDUALS APPEAR ON THESE PROJECT DOCUMENTS WITHIN THE SCOPE OF THEIR EMPLOYMENT AS REQUIRED BY ER1110-1-8152.
- THE INFORMATION DEPICTED ON THIS SURVEY MAP REPRESENTS THE RESULTS OF SURVEYS MADE ON THE DATES INDICATED AND CAN ONLY BE CONSIDERED AS INDICATING THE GENERAL CONDITIONS EXISTING AT THAT TIME. THESE CONDITIONS ARE SUBJECT TO RAPID CHANGE DUE TO SHOALING EVENTS. A PRUDENT MARINER SHOULD NOT RELY EXCLUSIVELY ON THE INFORMATION PROVIDED HERE. REQUIRED BY 33 CFR 209.325
- NAVIGATION AIDS LOCATED WITH DISTRICT SURVEY VESSEL, ACCURACY +/- 3 METERS.
- FOR THE MOST UP TO DATE INFORMATION PLEASE CHECK OUR WEBSITE AT: WWW.SAW.USACE.ARMY.MIL

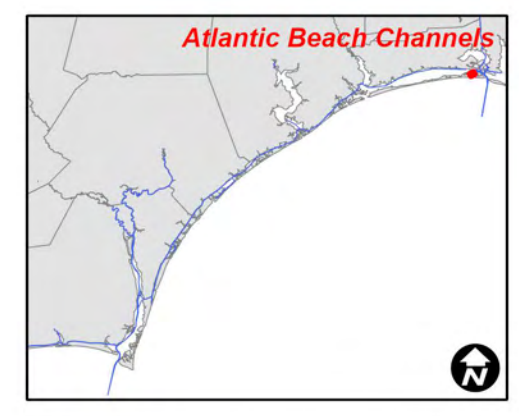

SURVEY DATE: 31 JULY 2023	SURVEYED BY: WJC, RWA
MAP DATE: 01 AUGUST 2023	MAPPED BY: K7OPNAGF
MAP SCALE: 1:2,000	PROCESSED BY: K7OPNAGF
IMAGERY DATE: 12 MAY 2023	
© 2023 MAXAR TECHNOLOGIES	MAP FILE NAME: SH_15_MON_20230731_CS

HYDROGRAPHIC SURVEY
 U.S. ARMY ENGINEER DISTRICT
 CORPS OF ENGINEERS
 WILMINGTON, NORTH CAROLINA

Atlantic Beach Channels Money Island Channel

ATLANTIC BEACH, NORTH CAROLINA